



First Floor

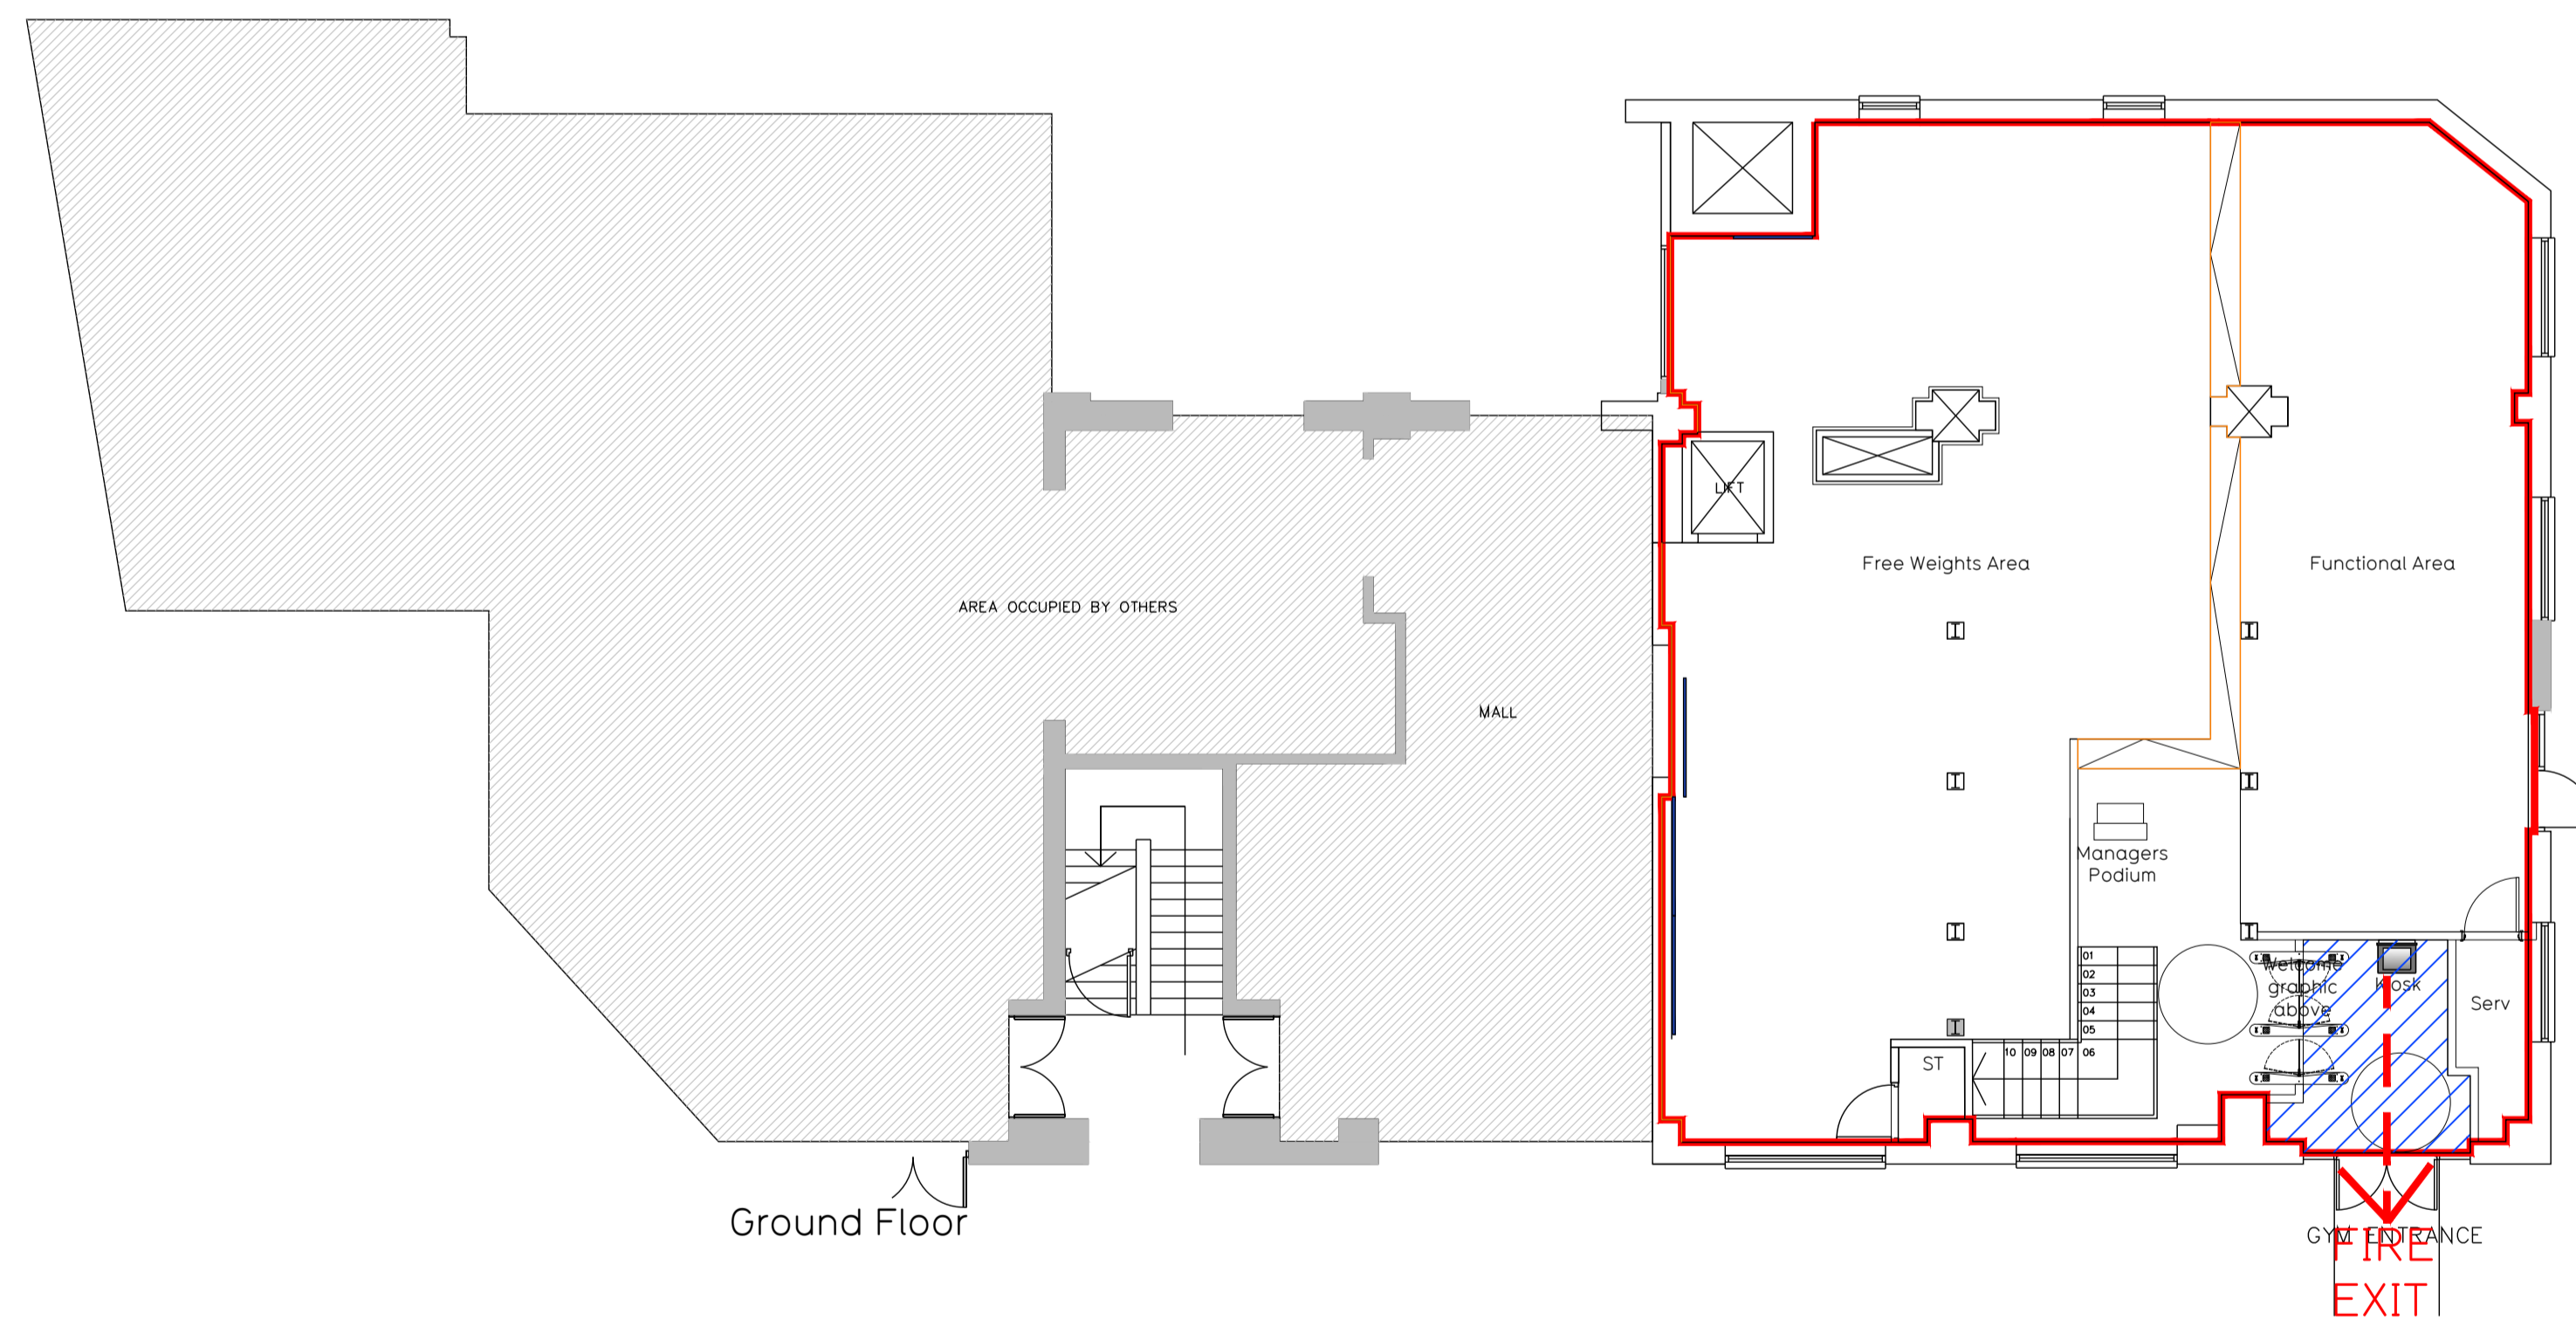


Ground Floor

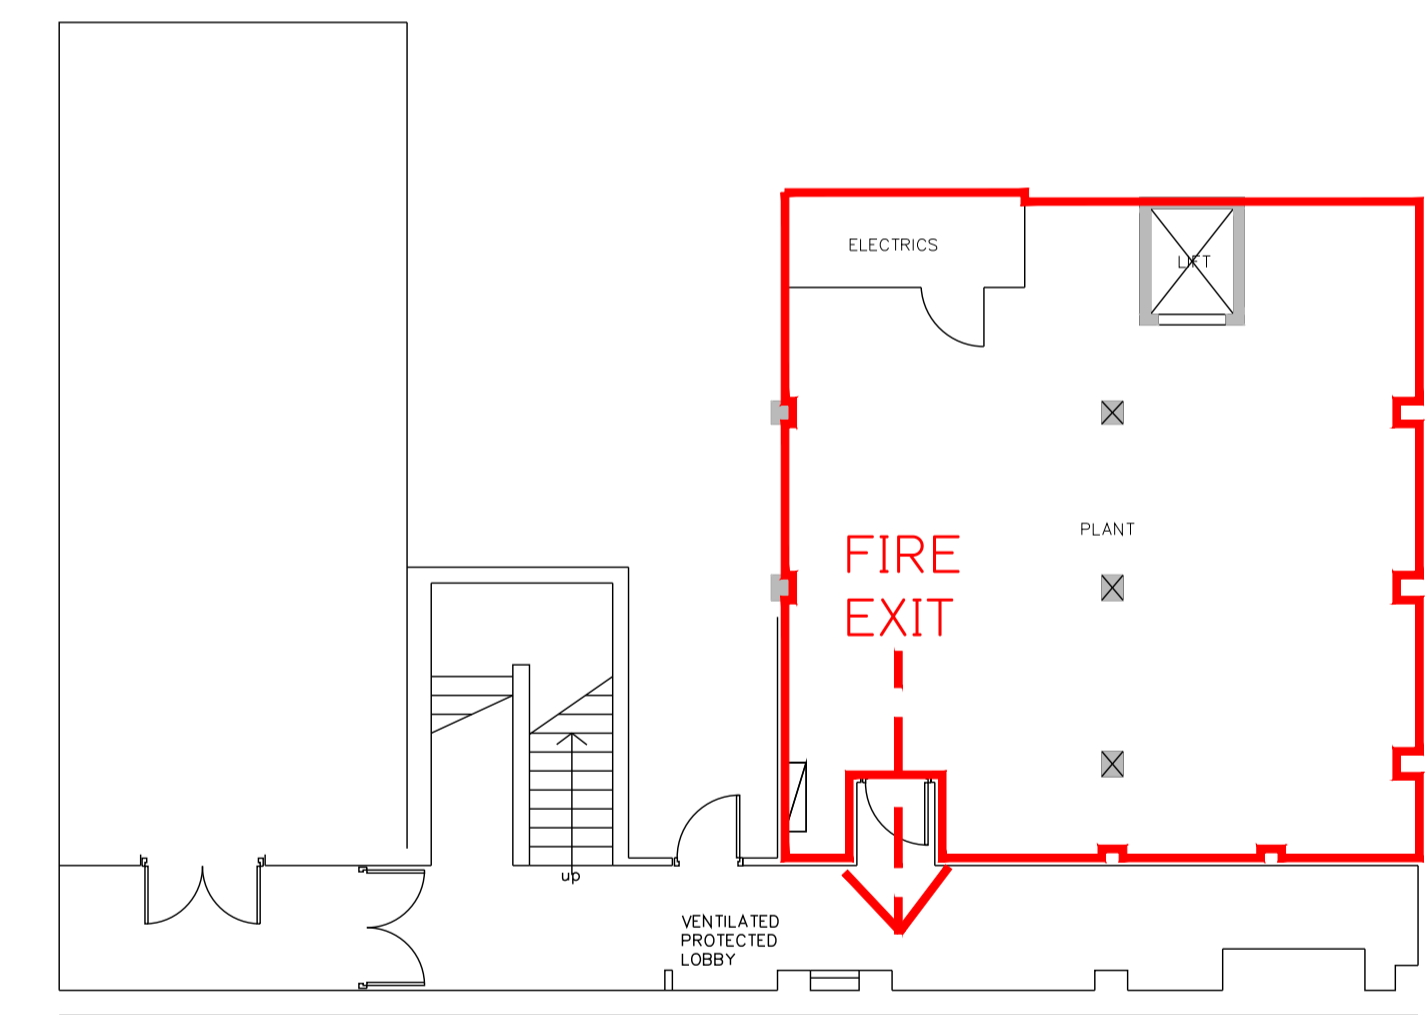

Basement

Rev	Date	Description	Drawn/	Checked
A	17.01.19	DRAWING UPDATED TO REFLECT AS-BUILT	GL	
PROJECT TITLE		DRAWING TITLE		
Project Victoria, Bow Wharf, 221 Grove Road, London, E3 5SN		Fire Evacuation Plan		
DESIGN CHECKED	DATE	SCALE	JOB No.	DRAWING No.
GL	16.01.19	1:100@A1	IA-PV-002	FEP-008
DRAWING PURPOSE				Rev
Construction				A



Pure Gym Ltd  
Town Centre House  
The Merlion Centre  
Leeds  
LS2 8LY

e: [architecture@puregym.com](mailto:architecture@puregym.com)  
t: 0113 285 8787  
w: [www.puregym.com](http://www.puregym.com)